RODRIGUEZ RESIDENCE

Cabinetry Approval Package

Oak Valley Estates - Lot 5 | Prepared September 9, 2026

Main House Proposal	Proposal 15841 - May 4, 2026	**$69,818.49**
Laundry and Master Closet	Proposal 16444 - September 9, 2026	**$45,586.18**
Combined proposal value		**$115,404.67**

PACKAGE CONTENTS

1. Main House Proposal 15841
2. Main House Layout dated August 27, 2026
3. Laundry and Master Closet Proposal 16444
4. Laundry and Master Closet Layout dated September 9, 2026

REVIEW NOTE

This package presents Stanley Kelsch's current design documents together with the actual main-house proposal on file. The August 27 email included a revised main-house invoice rather than a replacement proposal, so it is not represented here as a proposal.

CHANGE-ORDER BASIS

The combined proposal value above is provided for design approval and scope review. It is not yet the owner change-order amount. The existing cabinetry contract and prior subcontract change records carry conflicting main-house totals ($67,048.39, $71,770.65, and a later $68,748.42 invoice). Those records must be reconciled with the Rodriguez contract allowance and applicable contractor markup before the owner change order is issued.

OWNER APPROVAL **DATE**

Prepared by RAC Inc. for cabinetry scope and design review.

Peppermint Cabinets
1601 East 4340 South Circle St George Utah 84790

801-599-7047
https://www.peppermintcabinets.com/

PROPOSAL

Proposal Num.
15841

Proposal Name
RAC-Oak Valley Estates 5

Proposal Date
5/4/2026

Customer / Bill To

Craig Engel
(RAC) RAC Inc.
Email:
racinc19@gmail.com

Job Information

2129
RAC-Oak Valley Estates 5

Sales Rep:
Stanley Kelsch
801-599-7047
Stanley@peppermintcabinets.com
Proj. Manager: Annie

Description	Subtotal
RAC-Oak Valley Estates 5:	$69,818.49

Remarks

PROPOSAL TOTAL: $69,818.49

Contact Info

Terms and Conditions

1. Proposals created based upon drawings will be verified by field measuring the project. If there are variables, a change order will be submitted, and a price adjustment may be applied.
2. Peppermint Cabinets, LLC reserves the rights to review and modify the contract amounts (+or-) with client approval, if there are any changes, such as, but not limited to, these listed below.

A. Design changes, alternate material selections.
B. Additional items not specified in the original contract, or finish schedule.
C. Trip charges, for return trips, due to construction delays.

3. This proposal does not include any of the following, plumbing, electrical, drywall, patch, or paint.
4. Peppermint Cabinets, LLC will make every effort to protect the surrounding areas during the process.
5. The customer understands that the information on the order form is what is being ordered and agrees to accept the order as it is typed on the order form despite any previous conversations, text, emails, or other communications. Any changes to the order must be changed on the order form and the new order form must be approved.
6. Any warranty on this order is dictated by the manufacturer warranty that is in effect during the time of purchase. To obtain a copy of this warranty you may visit www.peppermintcabinets.com/warranty or contact Peppermint Cabinets, LLC directly.
7. The customers understand that cabinets made from natural wood have 'imperfections' (spots, shade variances, knots, etc). A solid wood cabinets door may not have fill matching grain or color. Changes cannot be made to these natural grain and color variations.
8. Solid color painted cabinets, especially white, off-white, or glazed finishes, may vary from the sample in tint or shade. This may be due to precision complexities and the delicate nature of the mixing process, finisher techniques, limited sample size or even sample age.
9. Attention: Due to ever increasing material, and labor costs. This proposal, if not accepted within 60 days, will be revised to conform to current marketing pricing.
10. In the event this account becomes past due and is sent to an outside collection agency, the Client/Contractor/Builder agrees to pay all related attorney fees, and filing fees. As well as charges incurred by hiring a collection agency.
11. Peppermint Cabinets, LLC has an Utah Business License and a license number is available upon request.
12. ALL PEPPERMINT CABINETS, LLC CUSTOMERS MUST PAY DEPOSIT OF 50% AT CONTRACT SIGNING, THEN A 40% PROGRESS PAYMENT WILL BE DUE AND REQUIRED UPON DELIVERY AND BEFORE INSTALLATION BEGINS, THEN THE REMAINING 10% WILL BE DUE UPON FINAL TOUCH UPS OF JOB. This will be in force unless separate terms have been written and agreed upon by client and Peppermint Cabinets.

A signature is required verifying that the terms and conditions have been read and understood. Please sign and date below.
I have read and agree to the terms and conditions herein.

CUSTOMER SIGNATURE:_____

Delivery Terms & Conditions

Peppermint Cabinets Delivery and Waiver Agreement
At Peppermint Cabinets, we are committed to delivering high-quality cabinetry to our customers in St. George and surrounding areas. To ensure a smooth delivery process, we require customers to confirm and adhere to the scheduled delivery date for their cabinet installation. This agreement outlines our delivery policies and the responsibilities of both parties.
Delivery Terms and Conditions

1. Delivery Date Confirmation:
The customer is responsible for selecting and confirming the delivery date for their cabinets. This date must align with the readiness of the home for cabinet installation, including completed construction, plumbing, electrical, and any other necessary preparations.
2. Failure to Be Ready for Delivery:
If the home is not ready for cabinet delivery on the confirmed date due to reasons within the customer's control, the customer must provide an alternative plan for delivery. An additional delivery fee will be charged for rescheduling, based on the scope and distance of the delivery.
3. Storage Fees for Produced Cabinets:
If the customer's project is delayed after the cabinets have been produced, Peppermint Cabinets will charge a storage fee of $50 per week for every 25 cabinets that need to be stored, until delivery can be rescheduled. 4. Rescheduling Availability:
Peppermint Cabinets operates on a 9–10 week scheduling timeline. If a delivery must be rescheduled due to the

customer's delay, the new delivery date will be subject to the next available slot in our schedule. We will work with you to accommodate your needs, but availability is not guaranteed.

5. Customer Responsibility:

The customer acknowledges that they have accurately communicated the readiness of their home for cabinet delivery and understand the financial and scheduling implications of any delays.


Customer Acknowledgment and Waiver:

I, the undersigned, confirm that I have selected and communicated the delivery date for my cabinet order with Peppermint Cabinets. I understand and agree to the terms outlined above, including any additional fees for storage or rescheduling if my home is not ready for delivery. I acknowledge that rescheduling is subject to Peppermint Cabinets' availability, and I will cooperate to ensure a smooth delivery process.


Signature: _____

Kitchen

1

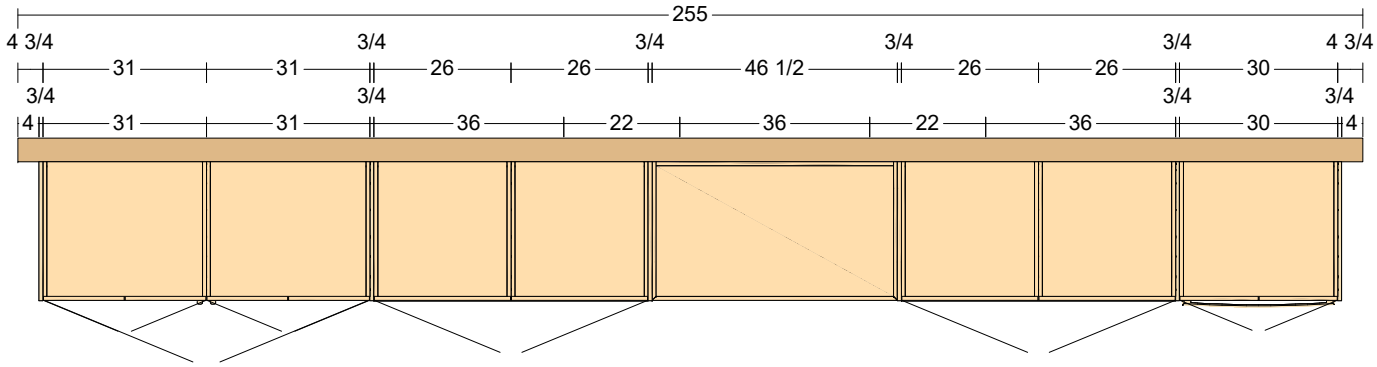


2

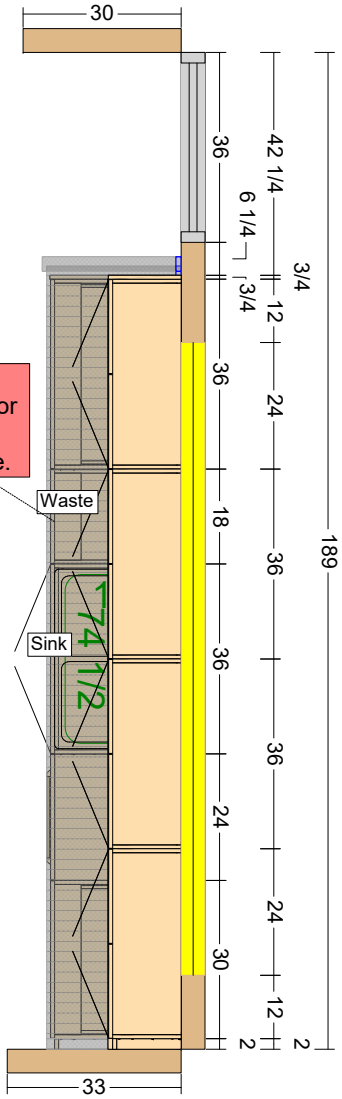

Builder Note:
Outlet needed inside for Waste roll out push to open electric hardware.

3

Builder Note:
Outlet needed inside for Waste roll out push to open electric hardware.

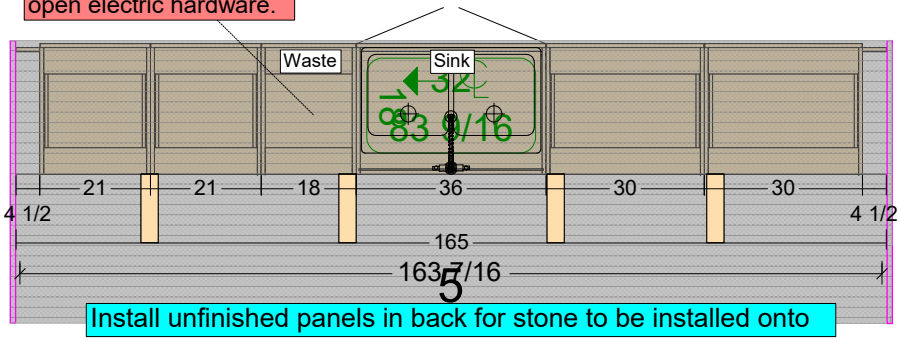

5

Install unfinished panels in back for stone to be installed onto

Stone will be on the back of the island

4

Peppermint Cabinets & More	Job: RAC-Oak Valley Estates 5	Address:	Scale: 1/2" = 1'	Page: 1/11
	Drawing Title: *Kitchen Top View*	Phone:	Date: 08/27/2026	
		E-Mail:	Revision: 1.0	











Peppermint Cabinets & More

Job: RAC-Oak Valley Estates 5	Address:	Scale: 1/2" = 1'	Page: 2/11
Drawing Title: *Kltchen*	Phone:	Date: 08/27/2026	
	E-Mail:	Revision: 1.0	


Wall #1

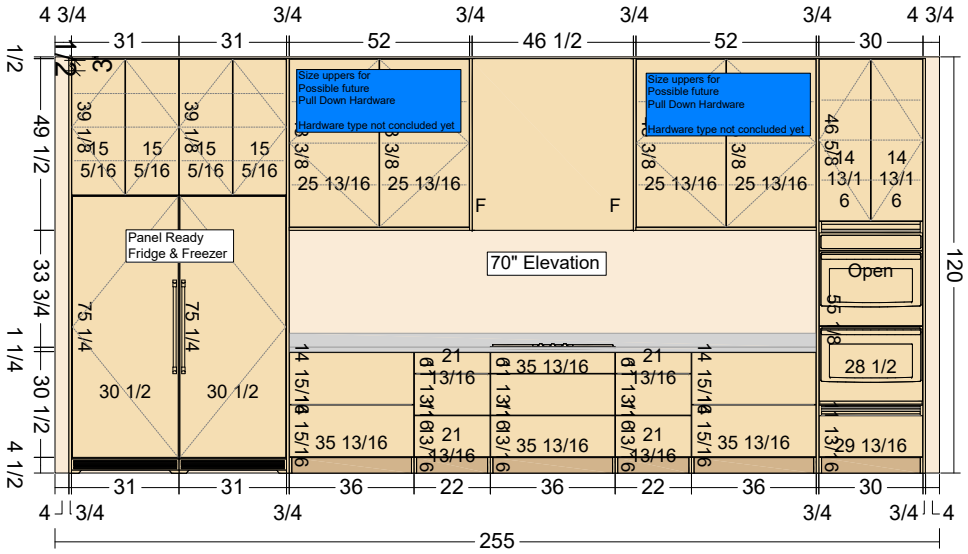


Wall #3

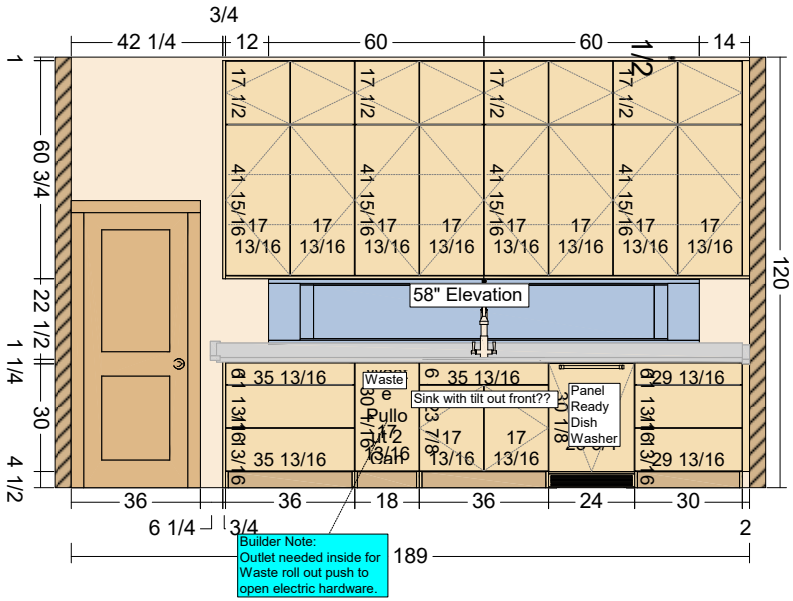

Wall #5

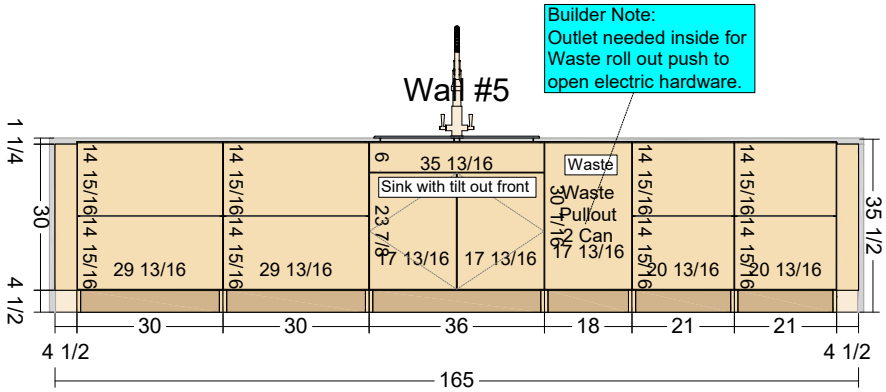


Wall #5 Back

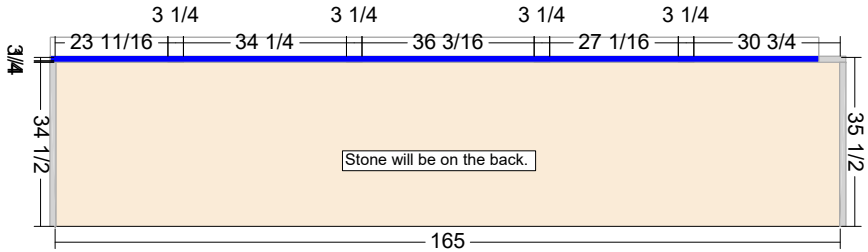


Peppermint Cabinets & More	Job: RAC-Oak Valley Estates 5	Address:	Scale: 1/2" = 1'	Page: 3/11
	Drawing Title: *Kitchen Elevations*	Phone:	Date: 08/27/2026	
		E-Mail:	Revision: 1.0	

Pantry

1

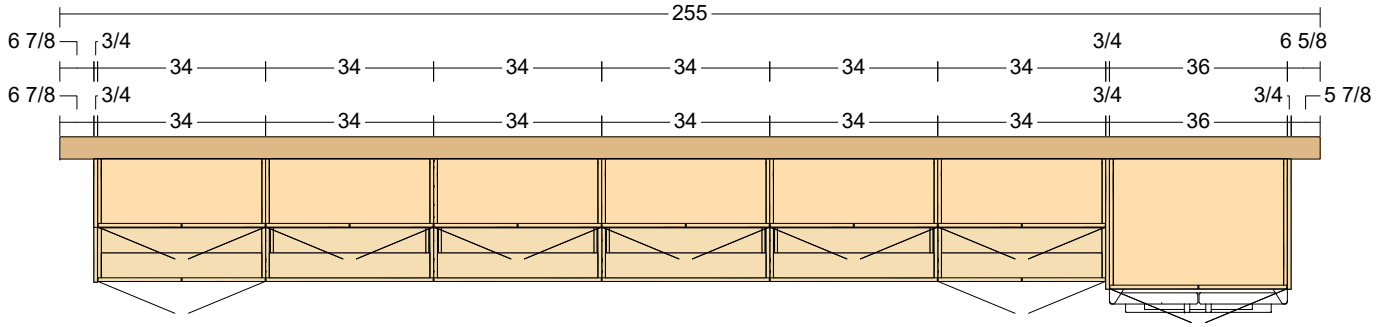

Wall #1

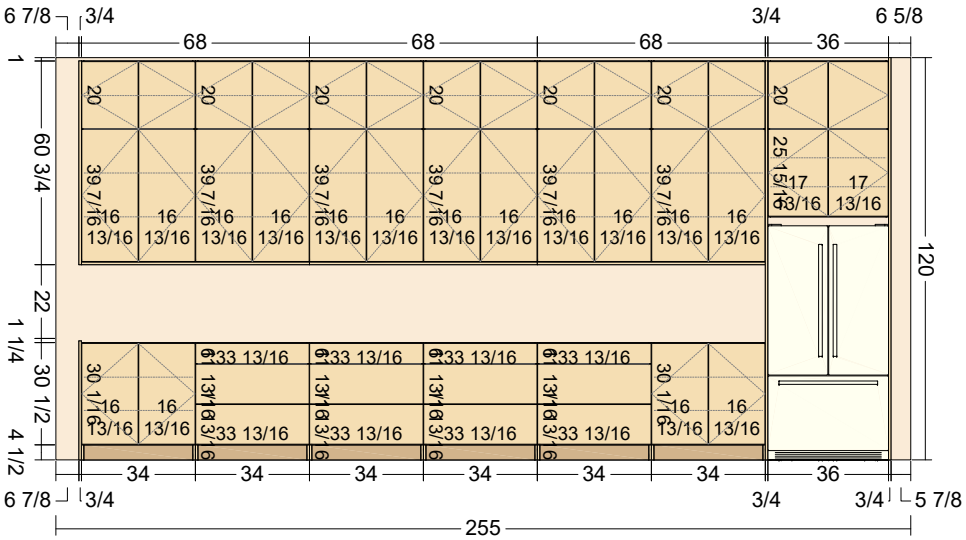




Peppermint Cabinets & More	Job: RAC-Oak Valley Estates 5	Address:	Scale: 1/2" = 1'	Page: 4/11
	Drawing Title: *Pantry*	Phone:	Date: 08/27/2026	
		E-Mail:	Revision: 1.0	


Powder Bath

2

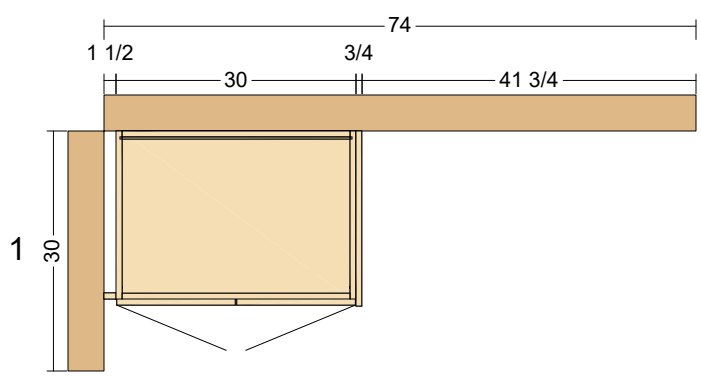




Wall #2

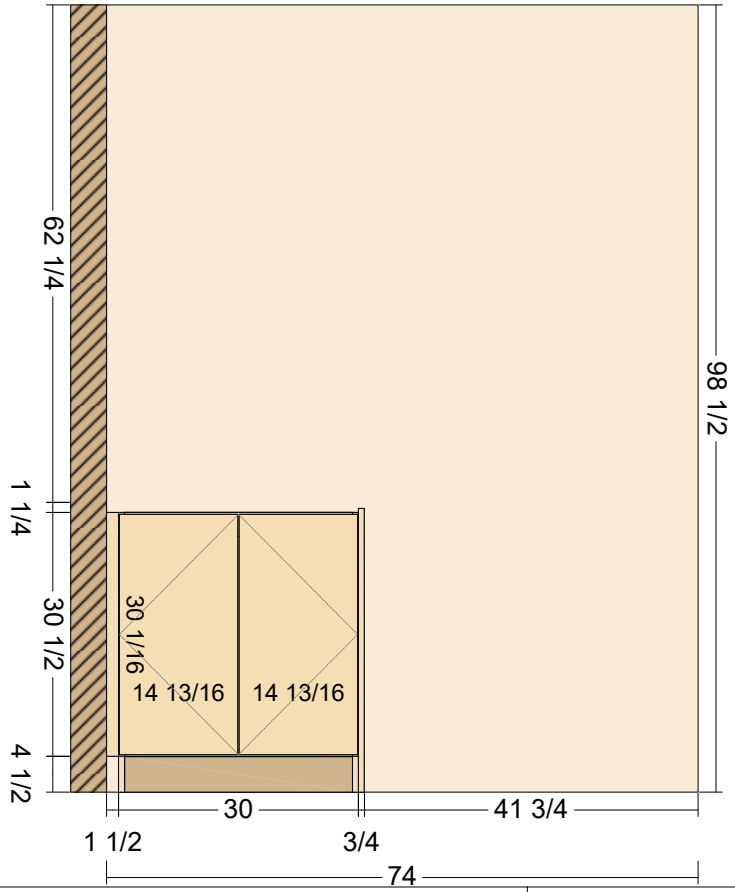


Peppermint Cabinets & More

Job: RAC-Oak Valley Estates 5	Address:	Scale: 1/2" = 1'	Page: 5/11
Drawing Title: ***Powder Bath***	Phone:	Date: 08/27/2026	
	E-Mail:	Revision: 1.0	

Office Bath

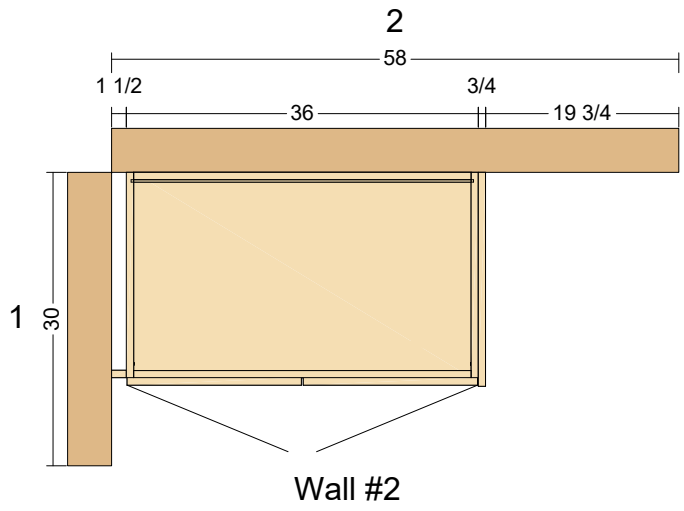



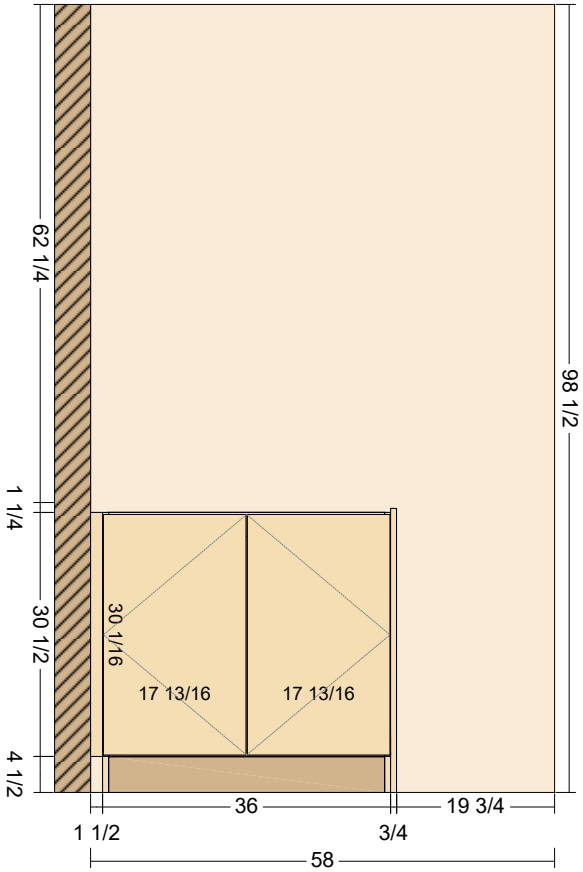


Peppermint Cabinets & More

Job: RAC-Oak Valley Estates 5	Address:	Scale: 1/2" = 1'	Page: 6/11
Drawing Title: *Office Bath*	Phone:	Date: 08/27/2026	
	E-Mail:	Revision: 1.0	


Master Bath

1

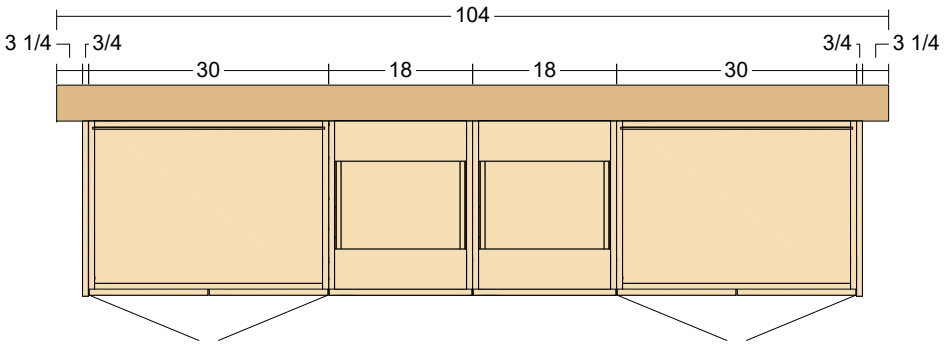




Wall #1

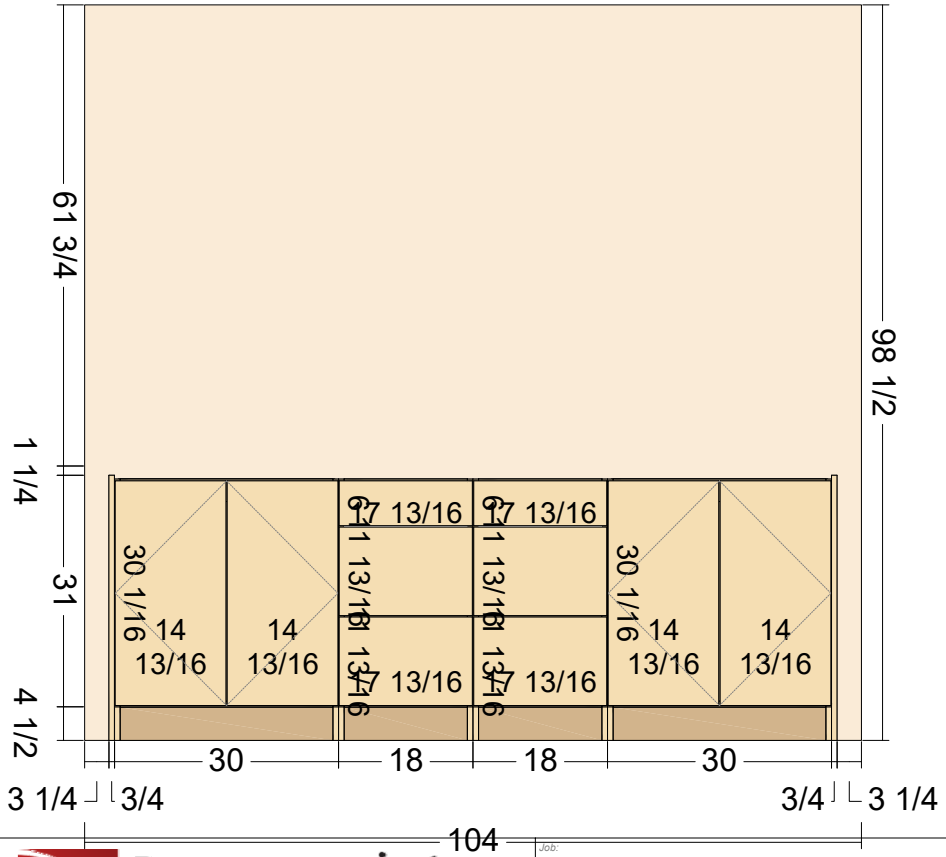

Peppermint Cabinets & More	Job: RAC-Oak Valley Estates 5	Address:	Scale: 1/2" = 1'	Page: 7/11
	Drawing Title: *Master Bath*	Phone:	Date: 08/27/2026	
		E-Mail:	Revision: 1.0	

Casita Kitchen

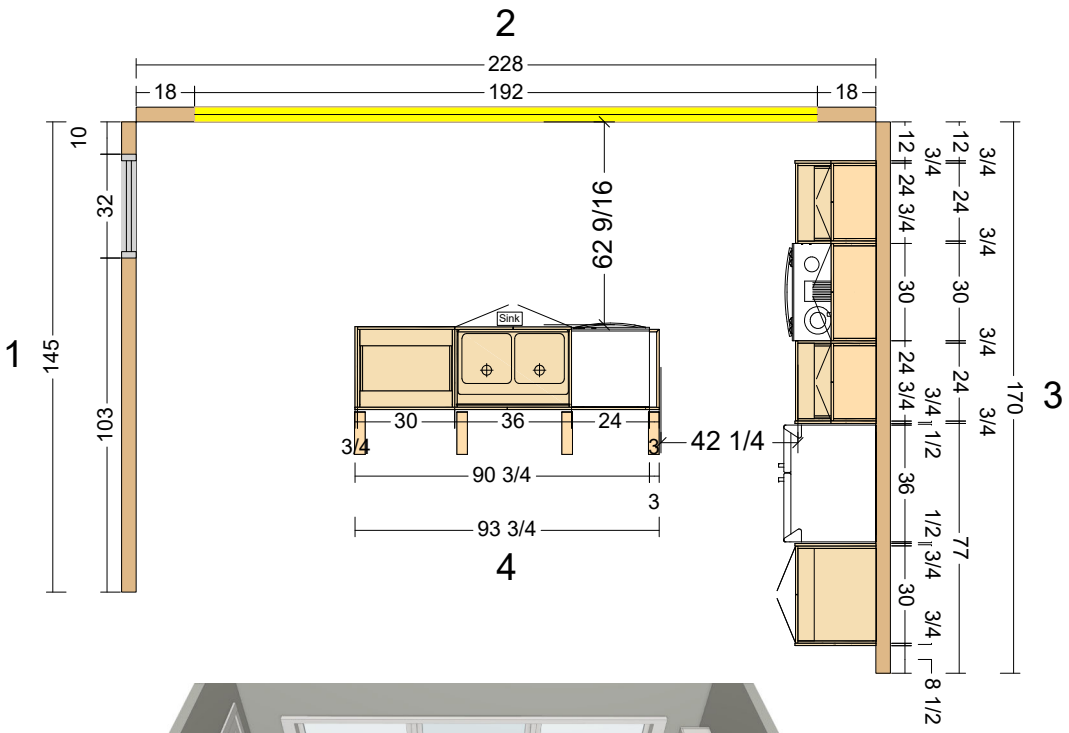











Peppermint Cabinets & More	Job: **RAC-Oak Valley Estates 5**	Address:	Scale: **1/2" = 1'**	Page: **8/11**
	Drawing Title: ***Casita Kitchen***	Phone:	Date: **08/27/2026**	
		E-Mail:	Revision: **1.0**	

Wall #3

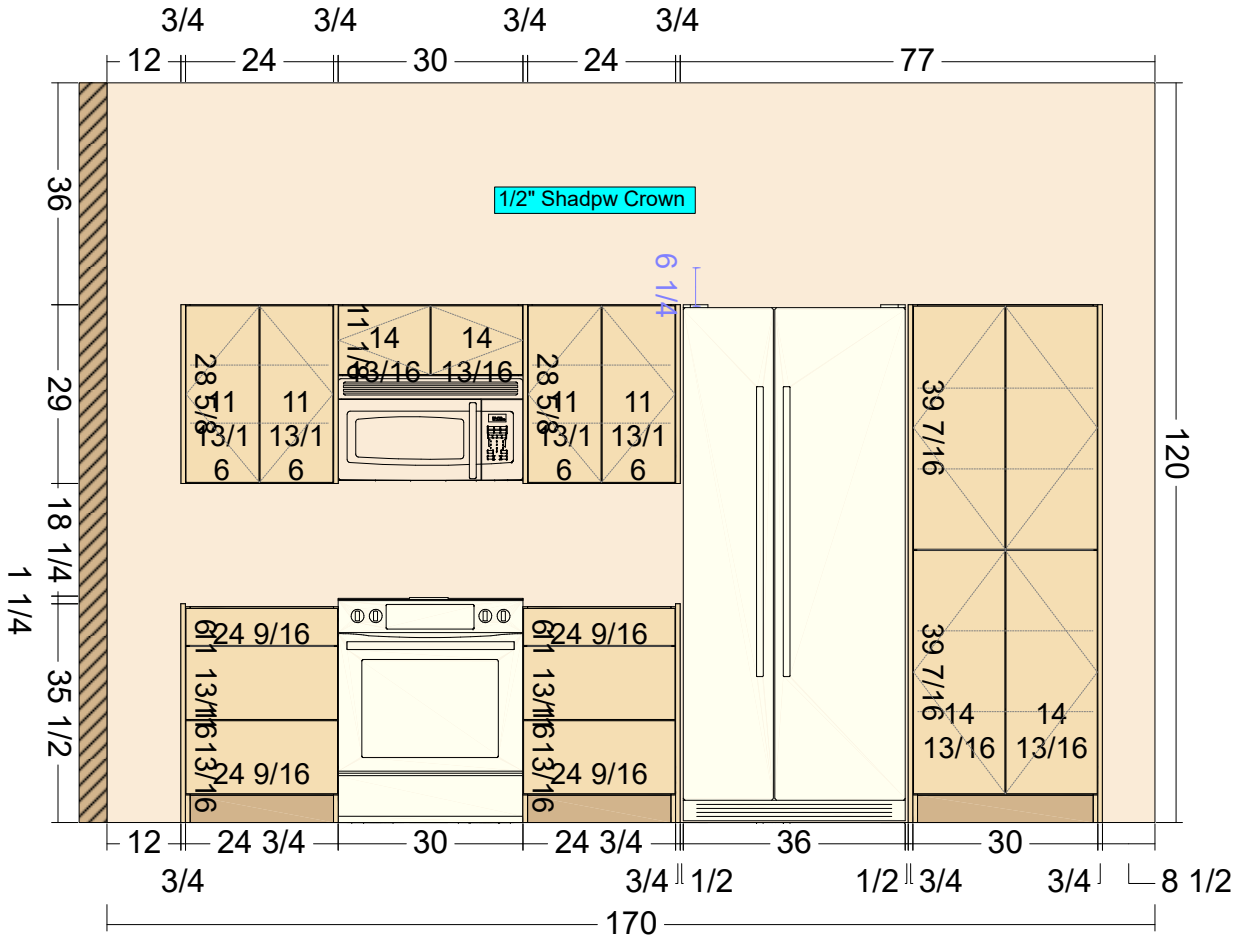

Wall #4

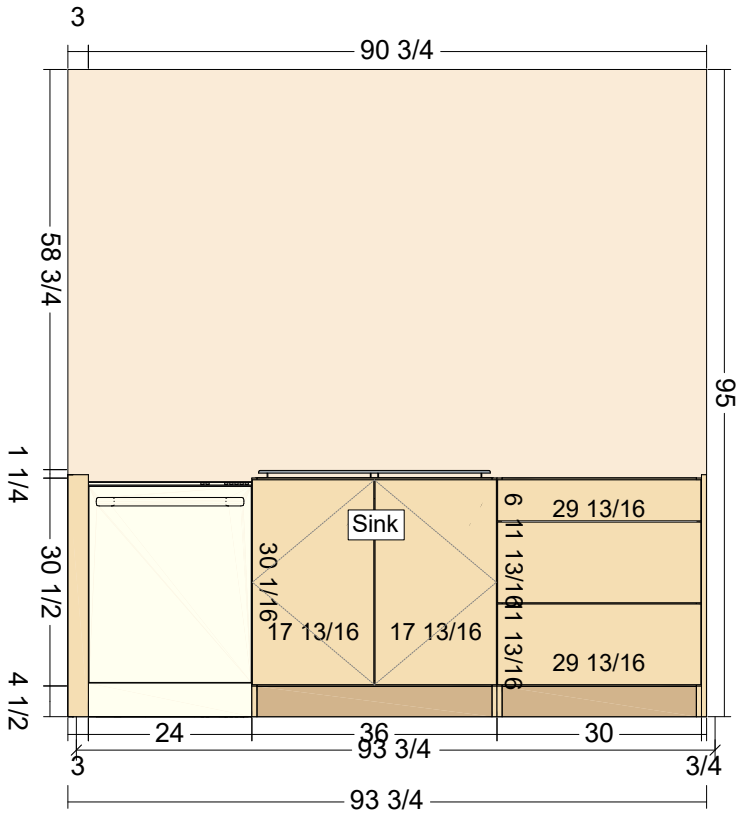


Peppermint Cabinets & More

Job: RAC-Oak Valley Estates 5	Address:	Scale: 1/2" = 1'	Page: 9/11
Drawing Title: *Casita Kitchen Elevations*	Phone:	Date: 08/27/2026	
	E-Mail:	Revision: 1.0	


Casita Bath ADU

1

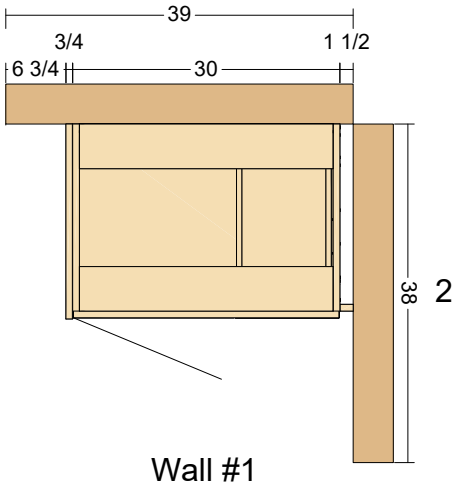




Wall #1

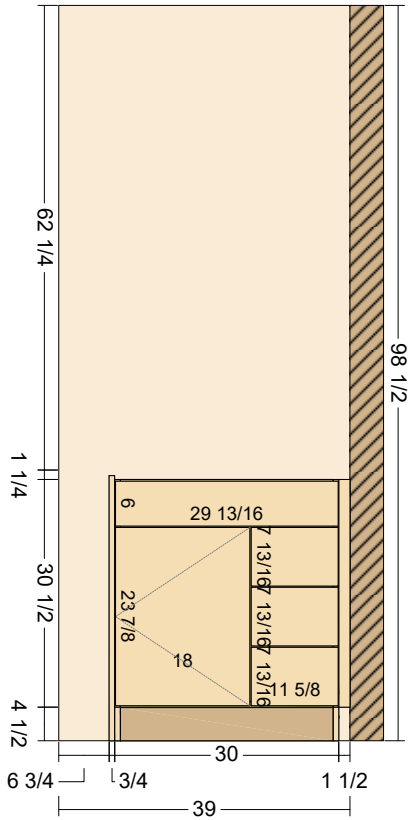


Peppermint Cabinets & More	Job: **RAC-Oak Valley Estates 5**	Address:	Scale: **1/2" = 1'**	Page: **10/11**
	Drawing Title: ***Casita Bath/ADU***	Phone:	Date: **08/27/2026**	
		E-Mail:	Revision: **1.0**	

Basement Bathroom



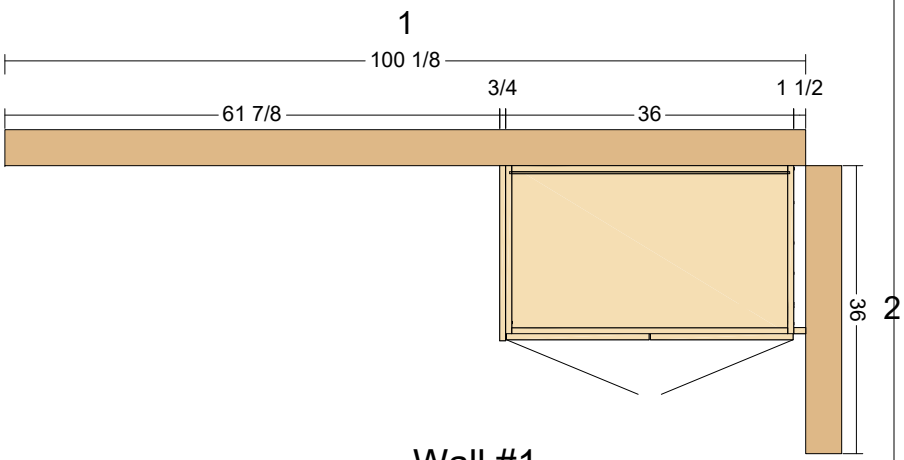

Wall #1

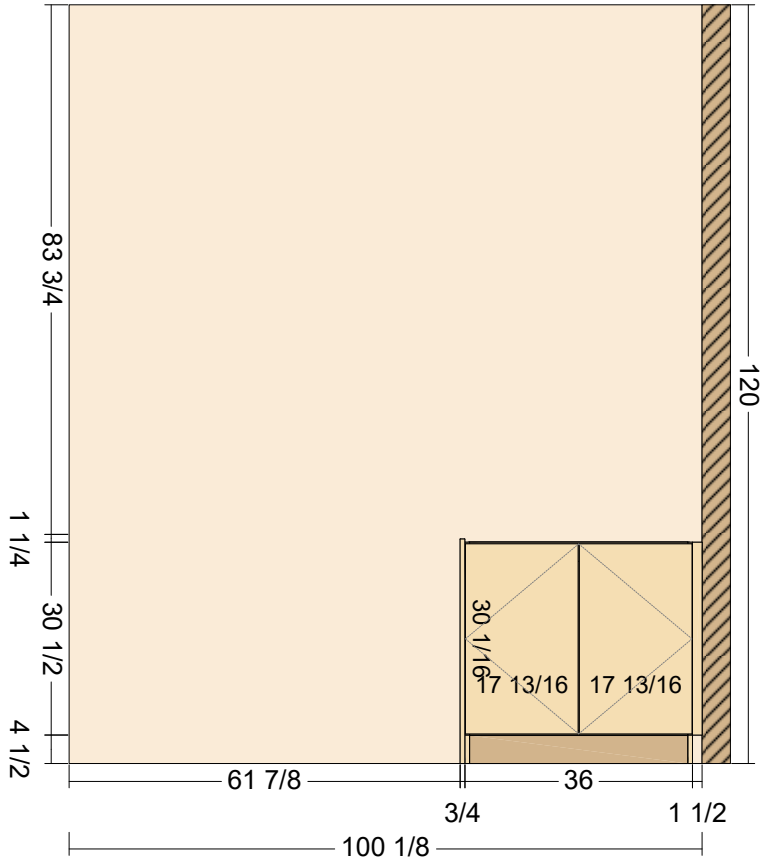

Peppermint Cabinets & More	Job: RAC-Oak Valley Estates 5	Address:	Scale: 1/2" = 1'	Page: 11/11
	Drawing Title: *Basement Bathroom*	Phone:	Date: 08/27/2026	
		E-Mail:	Revision: 1.0	

Peppermint Cabinets
1601 East 4340 South Circle St George Utah 84790

801-599-7047
https://www.peppermintcabinets.com/

PROPOSAL

Proposal Num.
16444

Proposal Name
RAC-Oak Valley Estates 5
Laundry & Closet

Proposal Date
9/9/2026

Customer / Bill To

Craig Engel
(RAC) RAC Inc.
Email:
racinc19@gmail.com

Job Information

RAC-Oak Valley Estates 5 Laundry & Closet

Sales Rep:
Stanley Kelsch
801-599-7047
Stanley@peppermintcabinets.com

Description	Subtotal
RAC-Oak Valley Estates 5 Laundry & Closet:	$45,586.18

Remarks

PROPOSAL TOTAL: $45,586.18

Contact Info

Terms and Conditions

1. Proposals created based upon drawings will be verified by field measuring the project. If there are variables, a change order will be submitted, and a price adjustment may be applied.
2. Peppermint Cabinets, LLC reserves the rights to review and modify the contract amounts (+or-) with client approval, if there are any changes, such as, but not limited to, these listed below.

A. Design changes, alternate material selections.
B. Additional items not specified in the original contract, or finish schedule.
C. Trip charges, for return trips, due to construction delays.

3. This proposal does not include any of the following, plumbing, electrical, drywall, patch, or paint.
4. Peppermint Cabinets, LLC will make every effort to protect the surrounding areas during the process.
5. The customer understands that the information on the order form is what is being ordered and agrees to accept the order as it is typed on the order form despite any previous conversations, text, emails, or other communications. Any changes to the order must be changed on the order form and the new order form must be approved.
6. Any warranty on this order is dictated by the manufacturer warranty that is in effect during the time of purchase. To obtain a copy of this warranty you may visit www.peppermintcabinets.com/warranty or contact Peppermint Cabinets, LLC directly.
7. The customers understand that cabinets made from natural wood have 'imperfections' (spots, shade variances, knots, etc). A solid wood cabinets door may not have fill matching grain or color. Changes cannot be made to these natural grain and color variations.
8. Solid color painted cabinets, especially white, off-white, or glazed finishes, may vary from the sample in tint or shade. This may be due to precision complexities and the delicate nature of the mixing process, finisher techniques, limited sample size or even sample age.
9. Attention: Due to ever increasing material, and labor costs. This proposal, if not accepted within 60 days, will be revised to conform to current marketing pricing.
10. In the event this account becomes past due and is sent to an outside collection agency, the Client/Contractor/Builder agrees to pay all related attorney fees, and filing fees. As well as charges incurred by hiring a collection agency.
11. Peppermint Cabinets, LLC has an Utah Business License and a license number is available upon request.
12. ALL PEPPERMINT CABINETS, LLC CUSTOMERS MUST PAY DEPOSIT OF 50% AT CONTRACT SIGNING, THEN A 40% PROGRESS PAYMENT WILL BE DUE AND REQUIRED UPON DELIVERY AND BEFORE INSTALLATION BEGINS, THEN THE REMAINING 10% WILL BE DUE UPON FINAL TOUCH UPS OF JOB. This will be in force unless separate terms have been written and agreed upon by client and Peppermint Cabinets.

A signature is required verifying that the terms and conditions have been read and understood. Please sign and date below.
I have read and agree to the terms and conditions herein.

CUSTOMER SIGNATURE:_____

Delivery Terms & Conditions

Peppermint Cabinets Delivery and Waiver Agreement
At Peppermint Cabinets, we are committed to delivering high-quality cabinetry to our customers in St. George and surrounding areas. To ensure a smooth delivery process, we require customers to confirm and adhere to the scheduled delivery date for their cabinet installation. This agreement outlines our delivery policies and the responsibilities of both parties.
Delivery Terms and Conditions

1. Delivery Date Confirmation:
The customer is responsible for selecting and confirming the delivery date for their cabinets. This date must align with the readiness of the home for cabinet installation, including completed construction, plumbing, electrical, and any other necessary preparations.
2. Failure to Be Ready for Delivery:
If the home is not ready for cabinet delivery on the confirmed date due to reasons within the customer's control, the customer must provide an alternative plan for delivery. An additional delivery fee will be charged for rescheduling, based on the scope and distance of the delivery.
3. Storage Fees for Produced Cabinets:
If the customer's project is delayed after the cabinets have been produced, Peppermint Cabinets will charge a storage fee of $50 per week for every 25 cabinets that need to be stored, until delivery can be rescheduled. 4. Rescheduling Availability:
Peppermint Cabinets operates on a 9–10 week scheduling timeline. If a delivery must be rescheduled due to the

customer's delay, the new delivery date will be subject to the next available slot in our schedule. We will work with you to accommodate your needs, but availability is not guaranteed.

5. Customer Responsibility:


The customer acknowledges that they have accurately communicated the readiness of their home for cabinet delivery and understand the financial and scheduling implications of any delays.

Customer Acknowledgment and Waiver:

I, the undersigned, confirm that I have selected and communicated the delivery date for my cabinet order with Peppermint Cabinets. I understand and agree to the terms outlined above, including any additional fees for storage or rescheduling if my home is not ready for delivery. I acknowledge that rescheduling is subject to Peppermint Cabinets' availability, and I will cooperate to ensure a smooth delivery process.

Signature: _____

Laundry Room

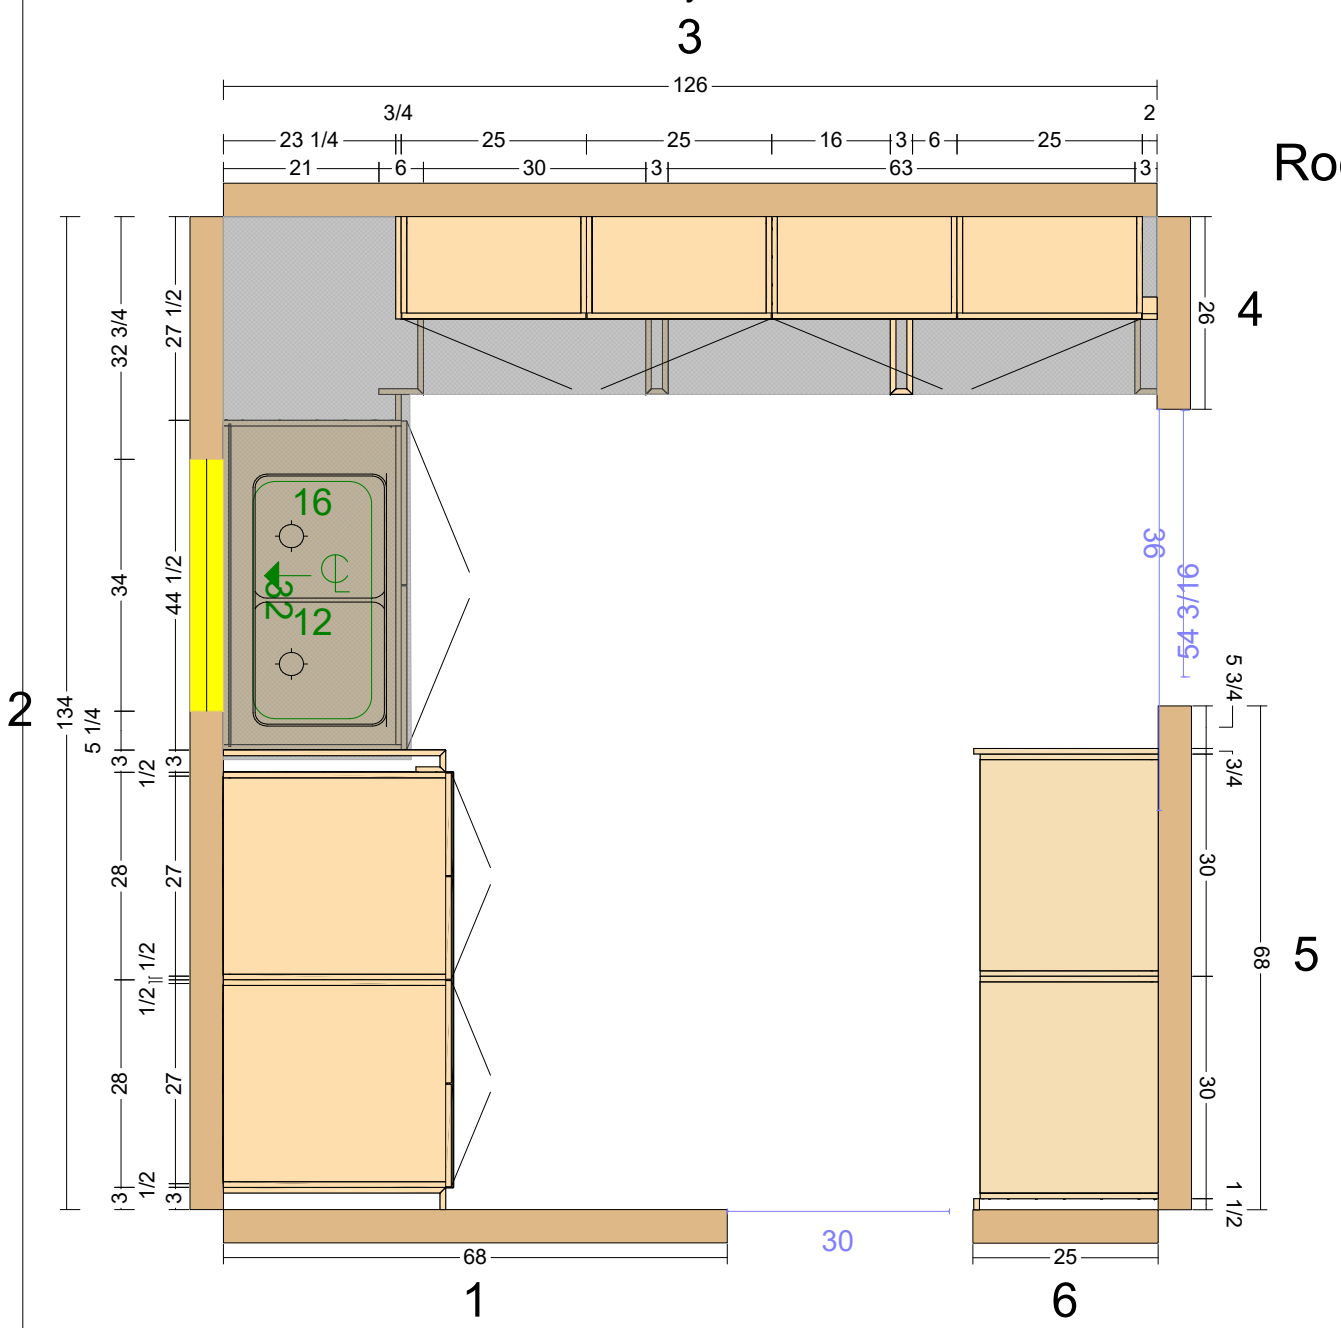

Rod Supports 1-3/16"





Oval Closet Rod – 5/8" x 1-3/16"

Peppermint Cabinets & More	Job: RAC-Oak Valley Estates 5 Laundry & Closet	Address:	Scale: 1/2" = 1'	Page: 1/7
	Drawing Title: *Laundry Top View*	Phone:	Date: 09/09/2026	
		E-Mail:	Revision: 1.0	







Peppermint Cabinets & More

Job: RAC-Oak Valley Estates 5 Laundry & Closet

Drawing Title: *Laundry 3D's*

Address:

Phone:

E-Mail:


Scale: 1/2" = 1'

Date: 09/09/2026


Revision: 1.0

Page: 2/7


Wall #2

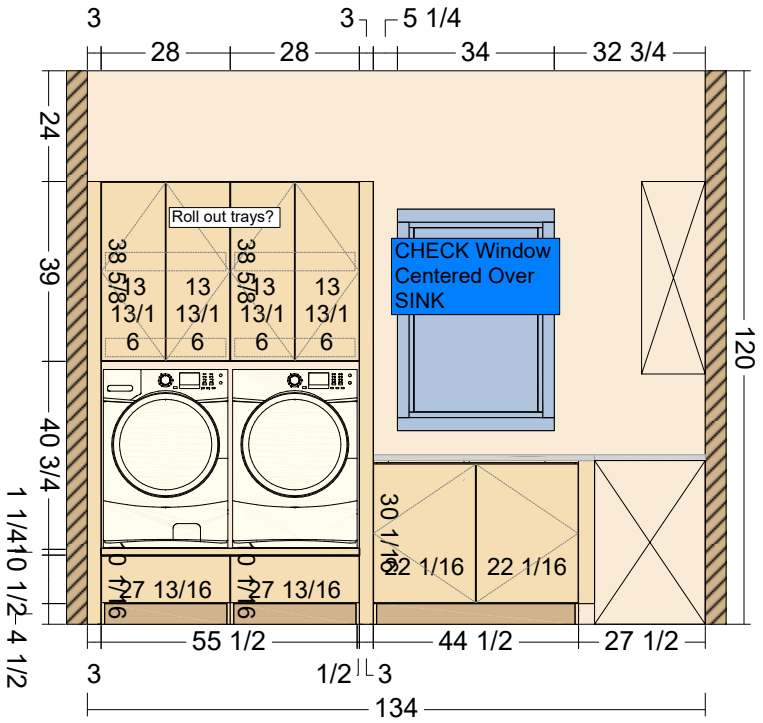

Wall #3

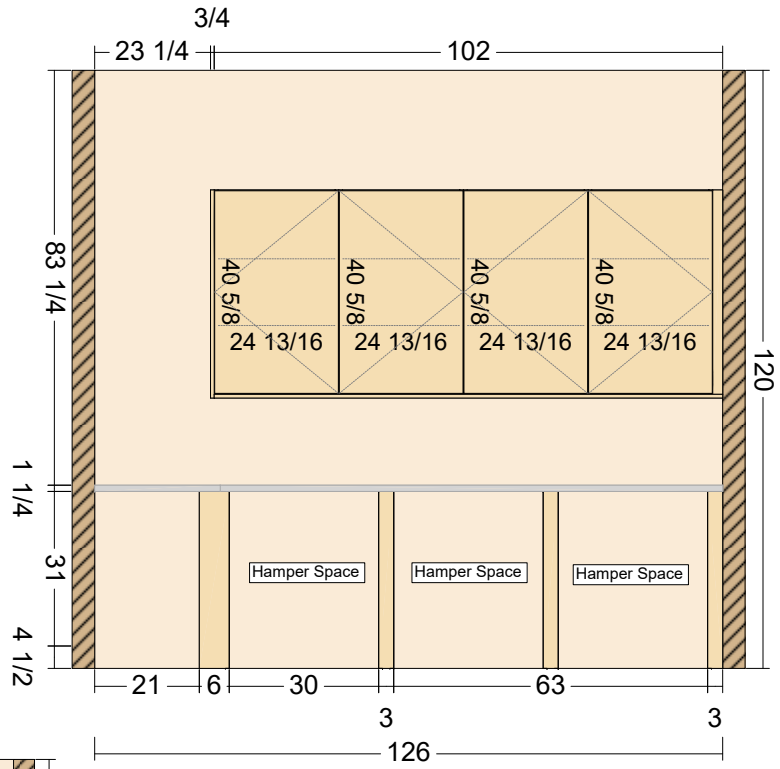


Wall #5

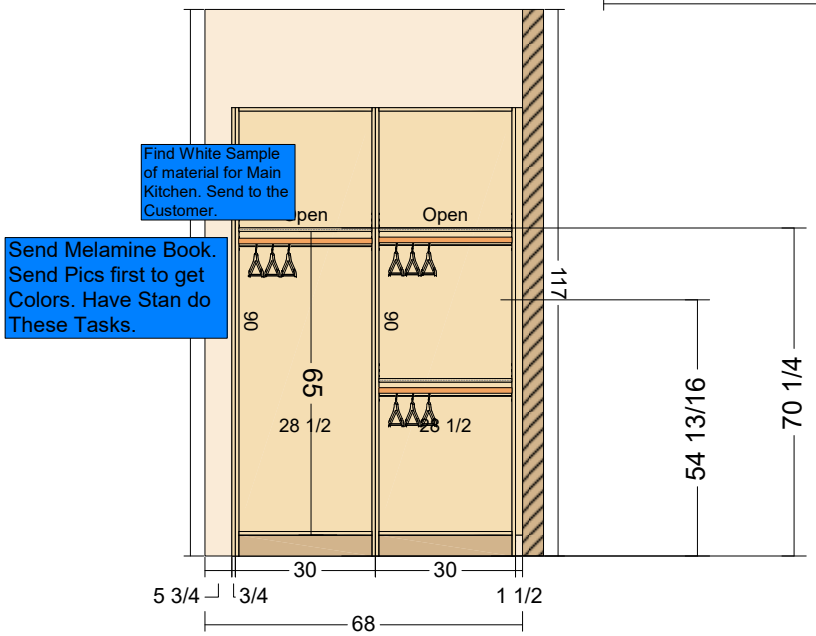

Peppermint Cabinets & More	Job: **RAC-Oak Valley Estates 5 Laundry & Closet**	Address:	Scale: **1/2" = 1'**	Page: **3/7**
	Drawing Title: ***Laundry***	Phone:	Date: **09/09/2026**	
		E-Mail:	Revision: **1.0**	

Closet

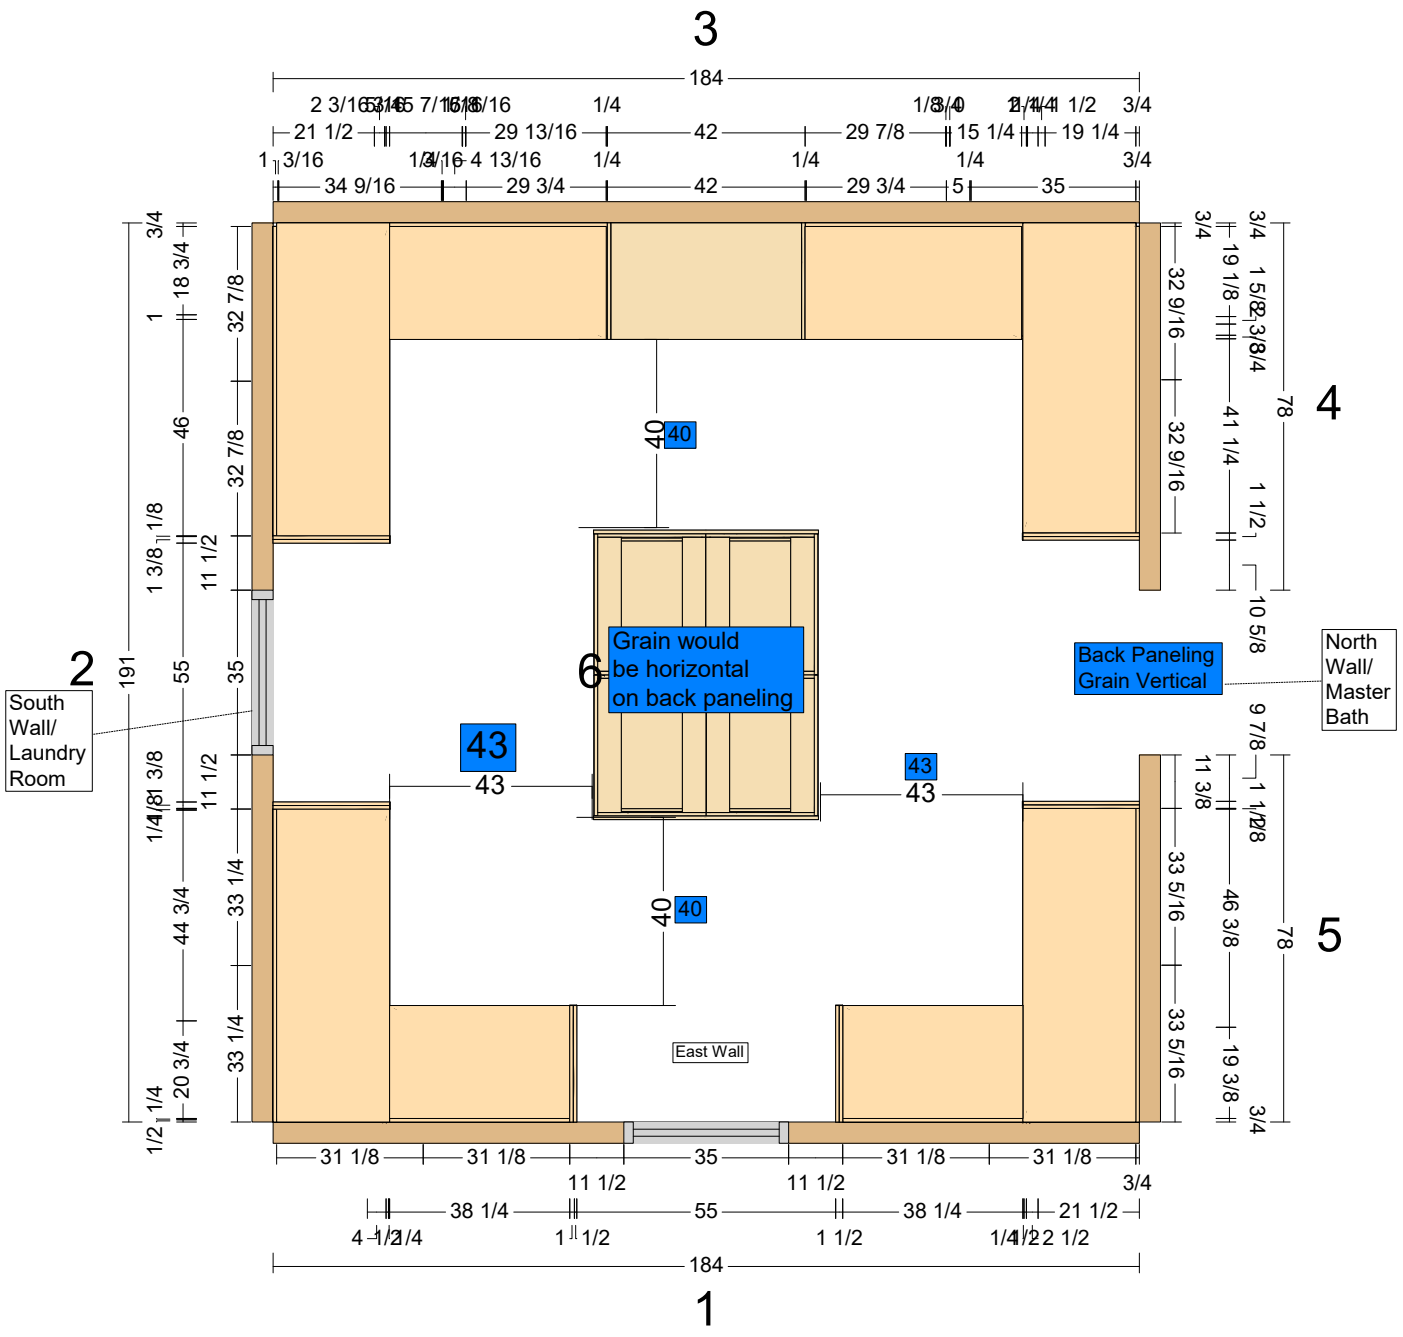



Supports 1-3/16"

Closet Rods will be black.



Oval Closet Rod – 5/8" x 1-3/16"

Peppermint Cabinets & More	Job: RAC-Oak Valley Estates 5 Laundry & Closet	Address:	Scale: 1/2" = 1'	Page: 4/7
	Drawing Title: *Closet*	Phone:	Date: 09/09/2026	
		E-Mail:	Revision: 1.0	










Peppermint Cabinets & More


Job: RAC-Oak Valley Estates 5 Laundry & Closet	Address:	Scale: 1/2" = 1'	Page: 5/7
Drawing Title: *Closet 3D Top View*	Phone:	Date: 09/09/2026	
	E-Mail:	Revision: 1.0	

Wall #1

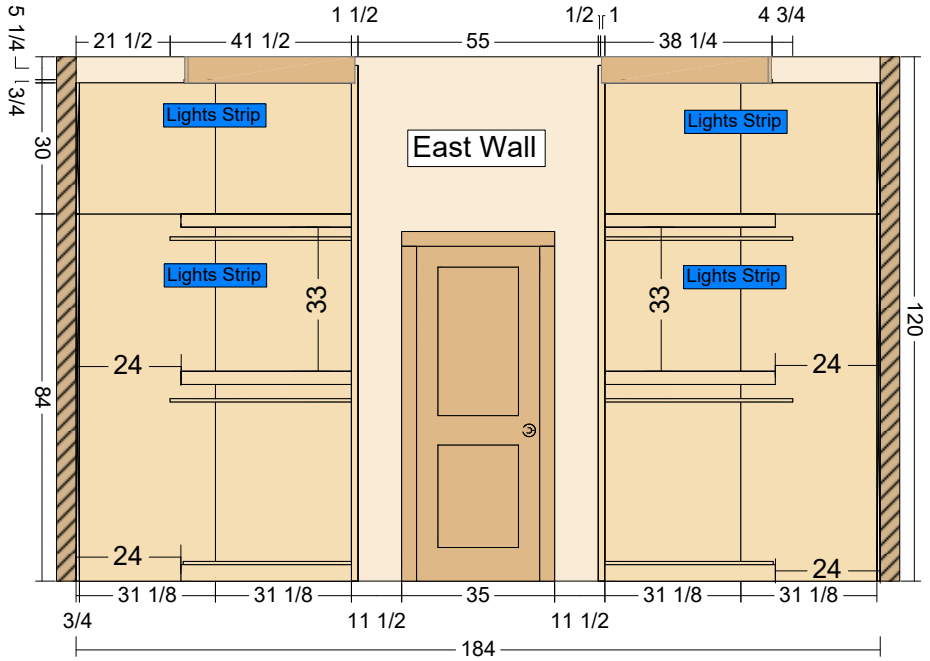




Wall #3

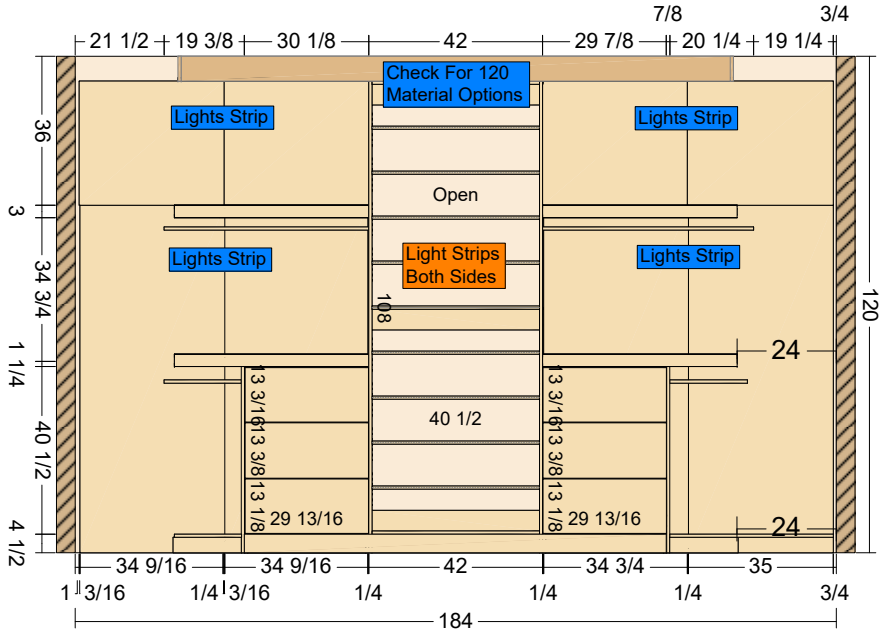




Peppermint Cabinets & More	Job: RAC-Oak Valley Estates 5 Laundry & Closet	Address:	Scale: 1/2" = 1'	Page: 6/7
	Drawing Title: *Closet Elevations & 3Ds*	Phone:	Date: 09/09/2026	
		E-Mail:	Revision: 1.0	

Wall #2

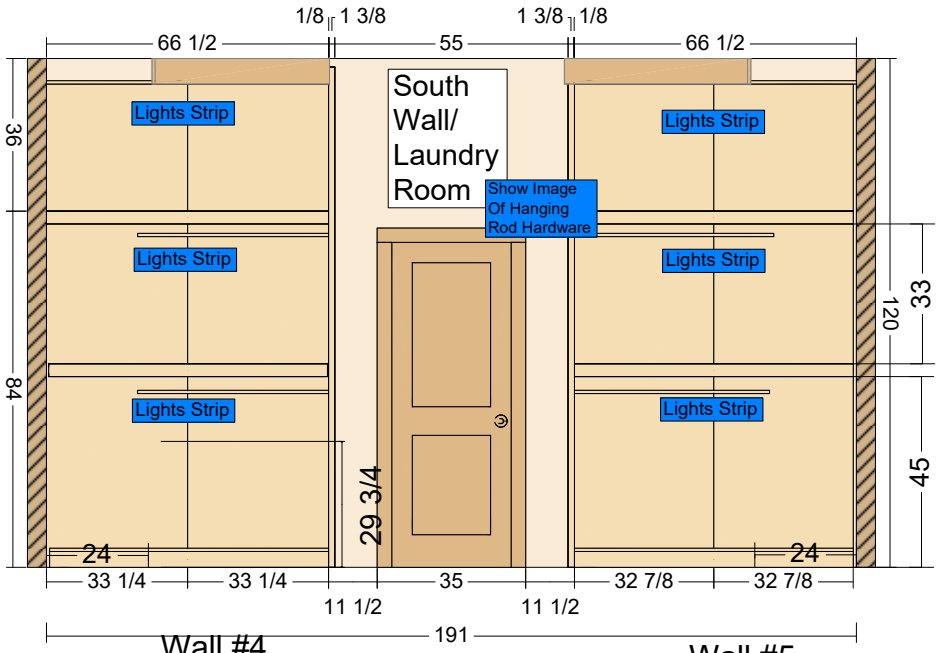




Wall #4

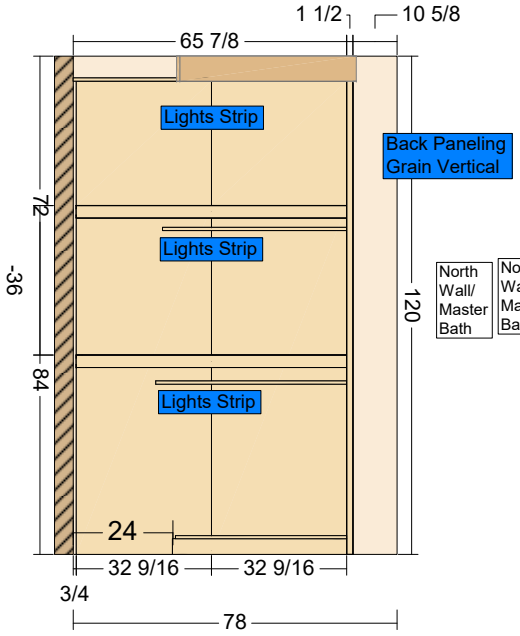

Wall #5

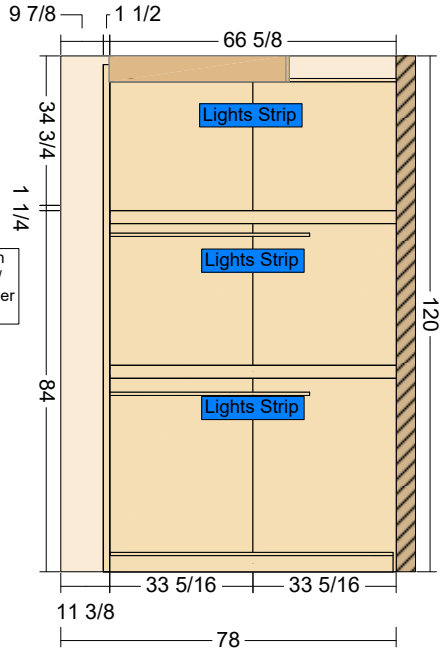



Peppermint Cabinets & More	Job: RAC-Oak Valley Estates 5 Laundry & Closet	Address:	Scale: 1/2" = 1'	Page: 7/7
	Drawing Title: *Closet Elevations*	Phone:	Date: 09/09/2026	
		E-Mail:	Revision: 1.0	